

1/13/18 bk - Fixes for missing ground, substitute transformer, higher Fsw LT3439, comment non-standard 12V pinout, substitute MOSFETs and TVS.


TITLE PPM I Overview

FILE: 01-overview.sch

REVISION: 1.9

PAGE 1 OF 14

DRAWN BY: Bradley Worley

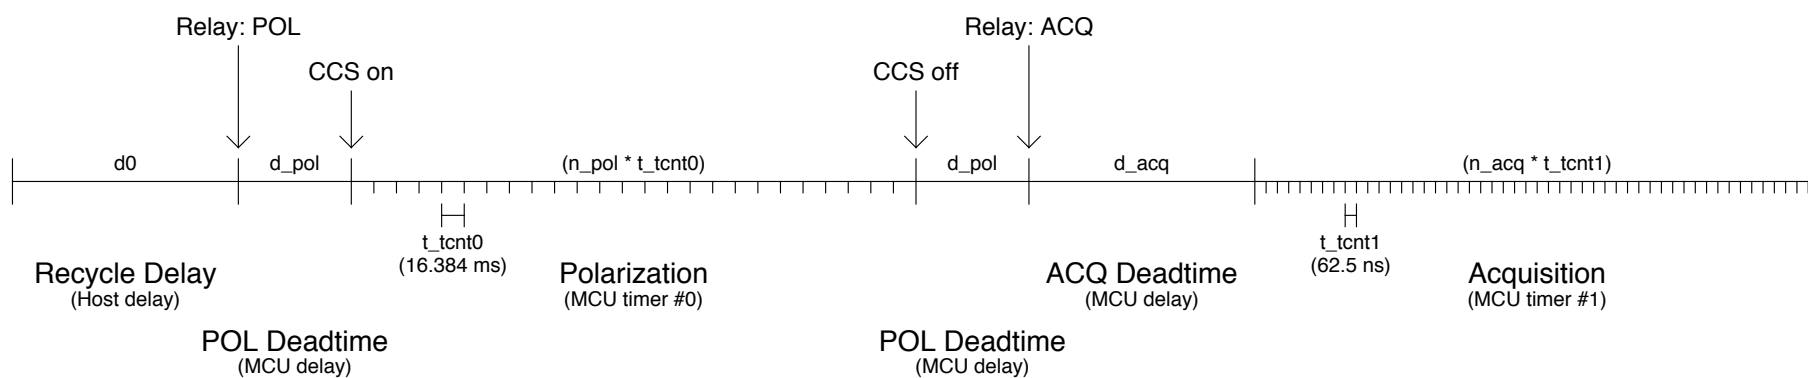


TITLE **PPM I Experiment**

FILE: 02-pulprog.sch

REVISION: 1.2

PAGE 2 OF 14

DRAWN BY: Bradley Worley

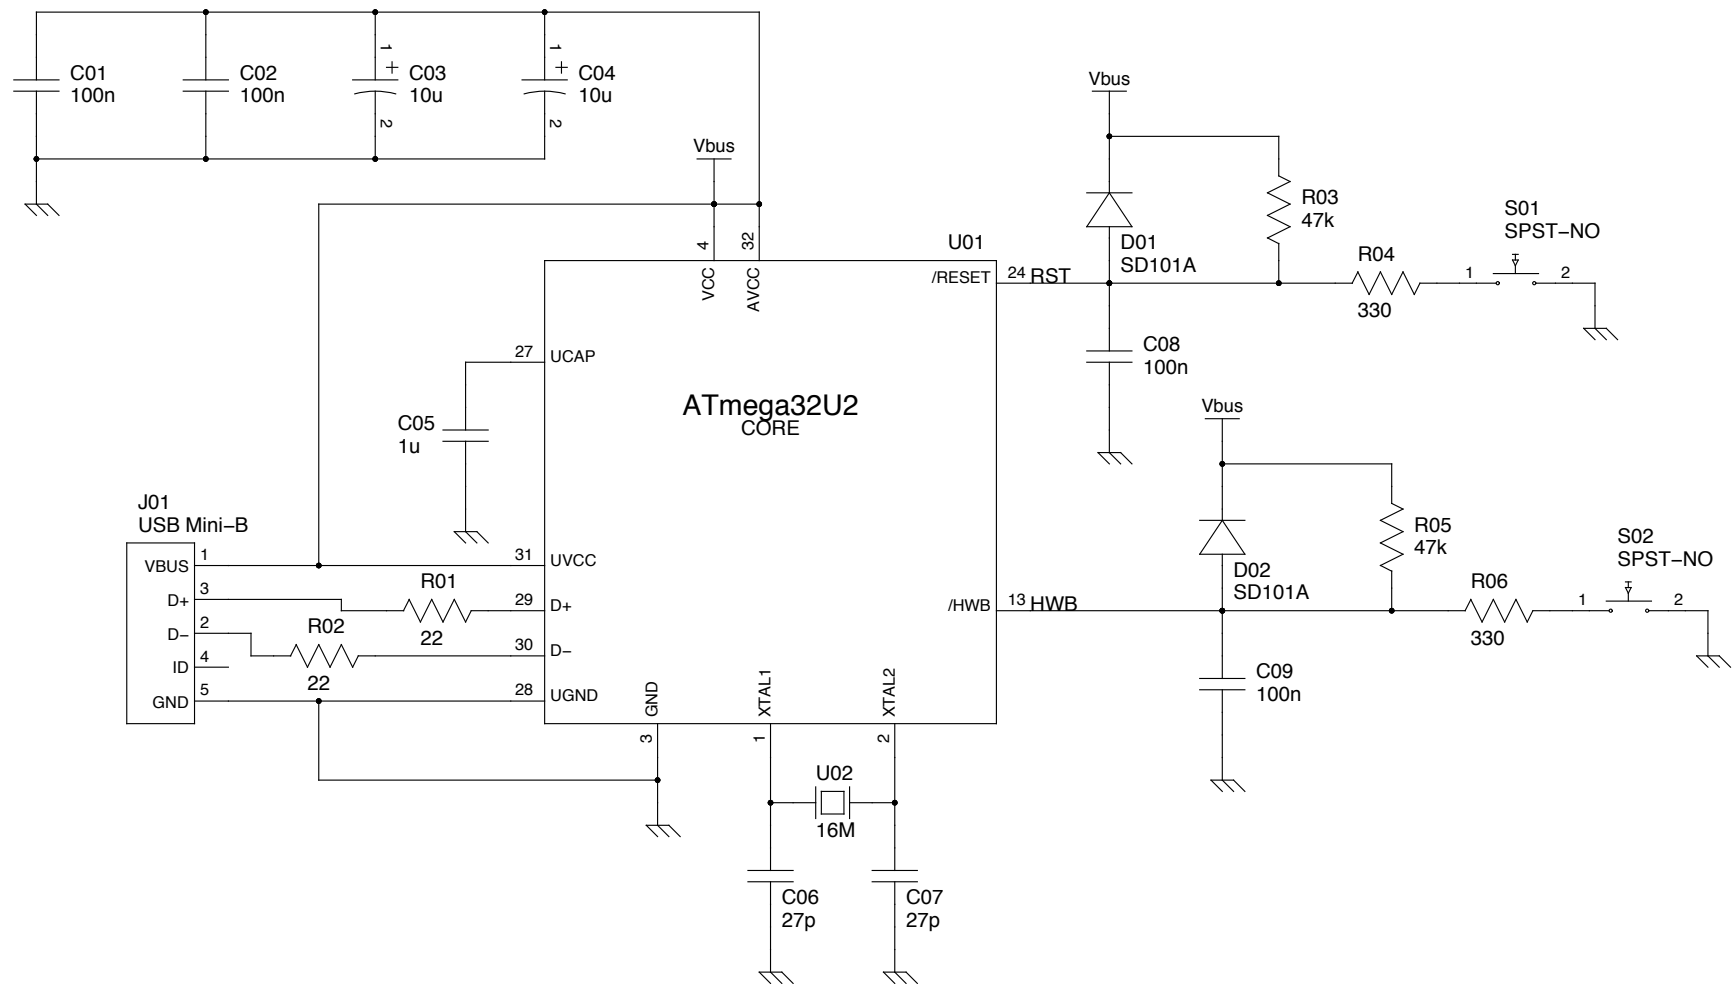




TITLE PPM I Microcontroller Core

FILE: 03-mcu-core.sch

REVISION: 1.3

PAGE 3 OF 14

DRAWN BY: Bradley Worley

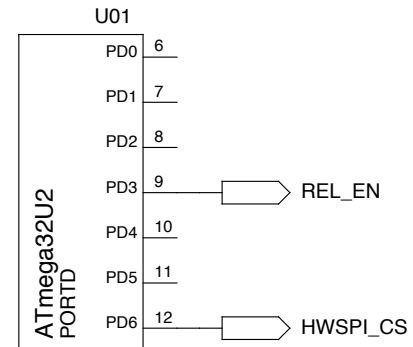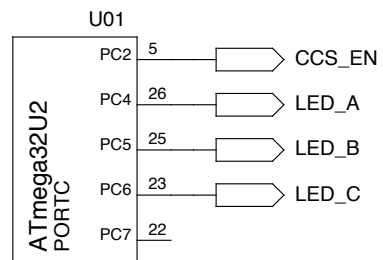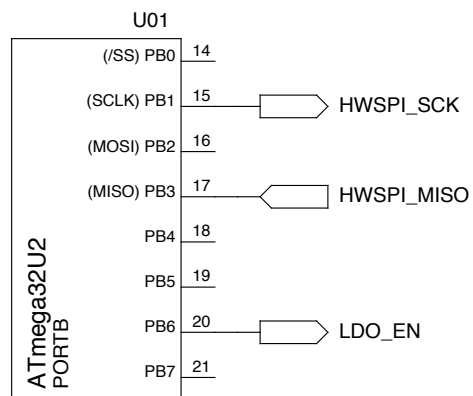


TITLE **PPM I Microcontroller I/O Ports**

FILE: 04-mcu-ports.sch


REVISION: 1.3

PAGE 4 OF 14

DRAWN BY: Bradley Worley

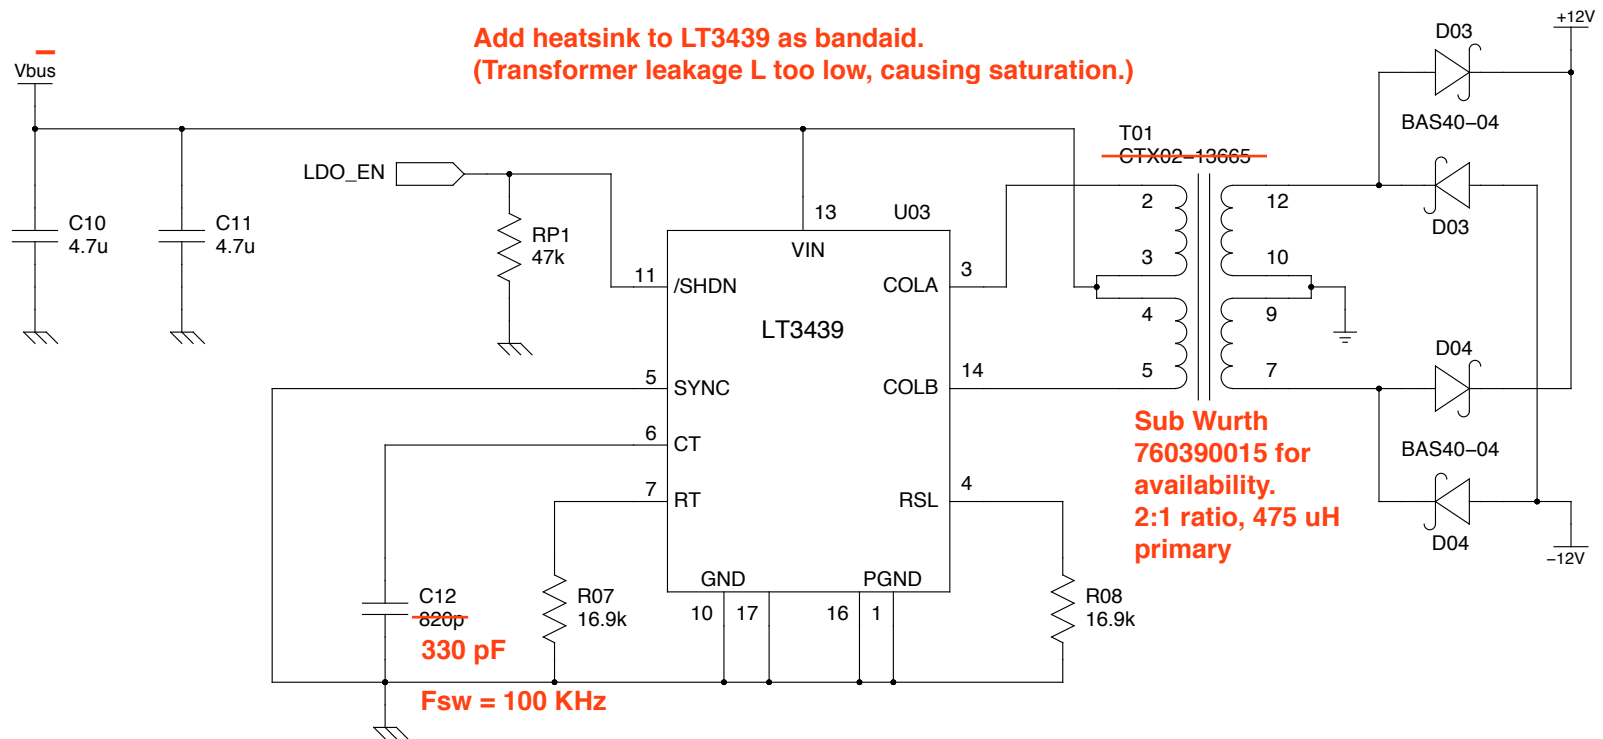

**Short GNDs together.
ADC digital side is not isolated.**

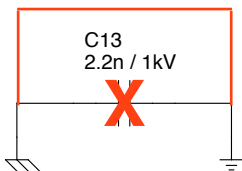


TITLE **PPM I DC/DC Transformer Driver**

FILE: 05-dcdc.sch

REVISION: 1.0

PAGE 5 OF 14

DRAWN BY: Bradley Worley

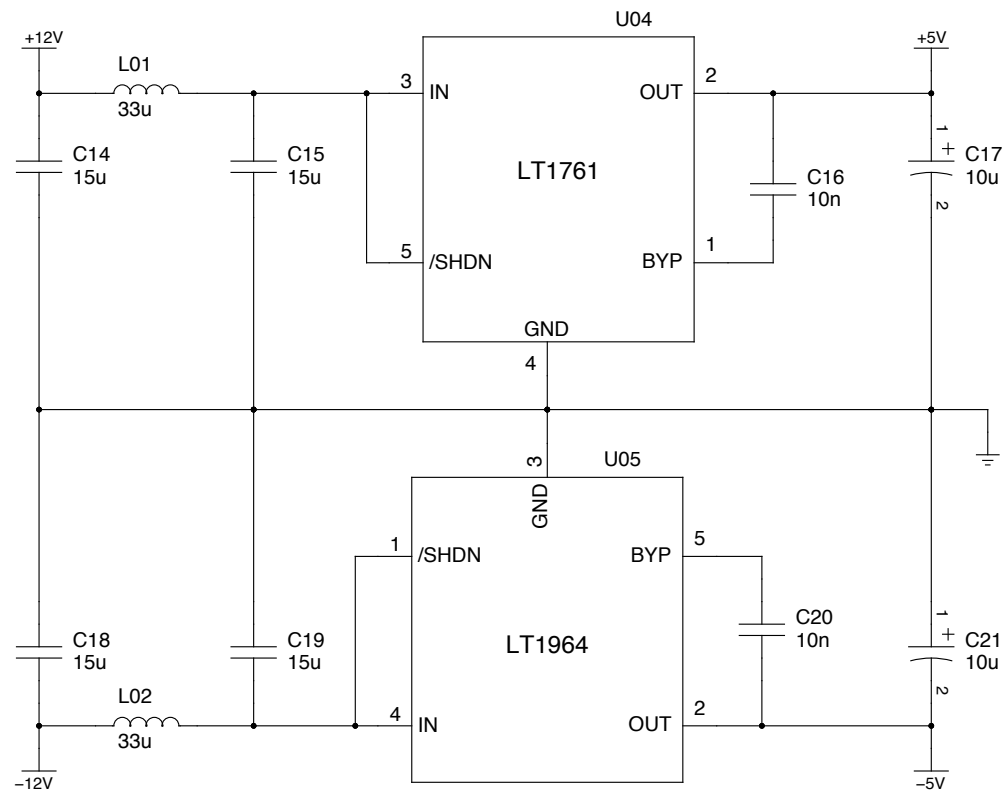


TITLE **PPM I Low-Dropout Regulators**

FILE: 06-lldo.sch

REVISION: 1.0

PAGE 6 OF 14

DRAWN BY: Bradley Worley

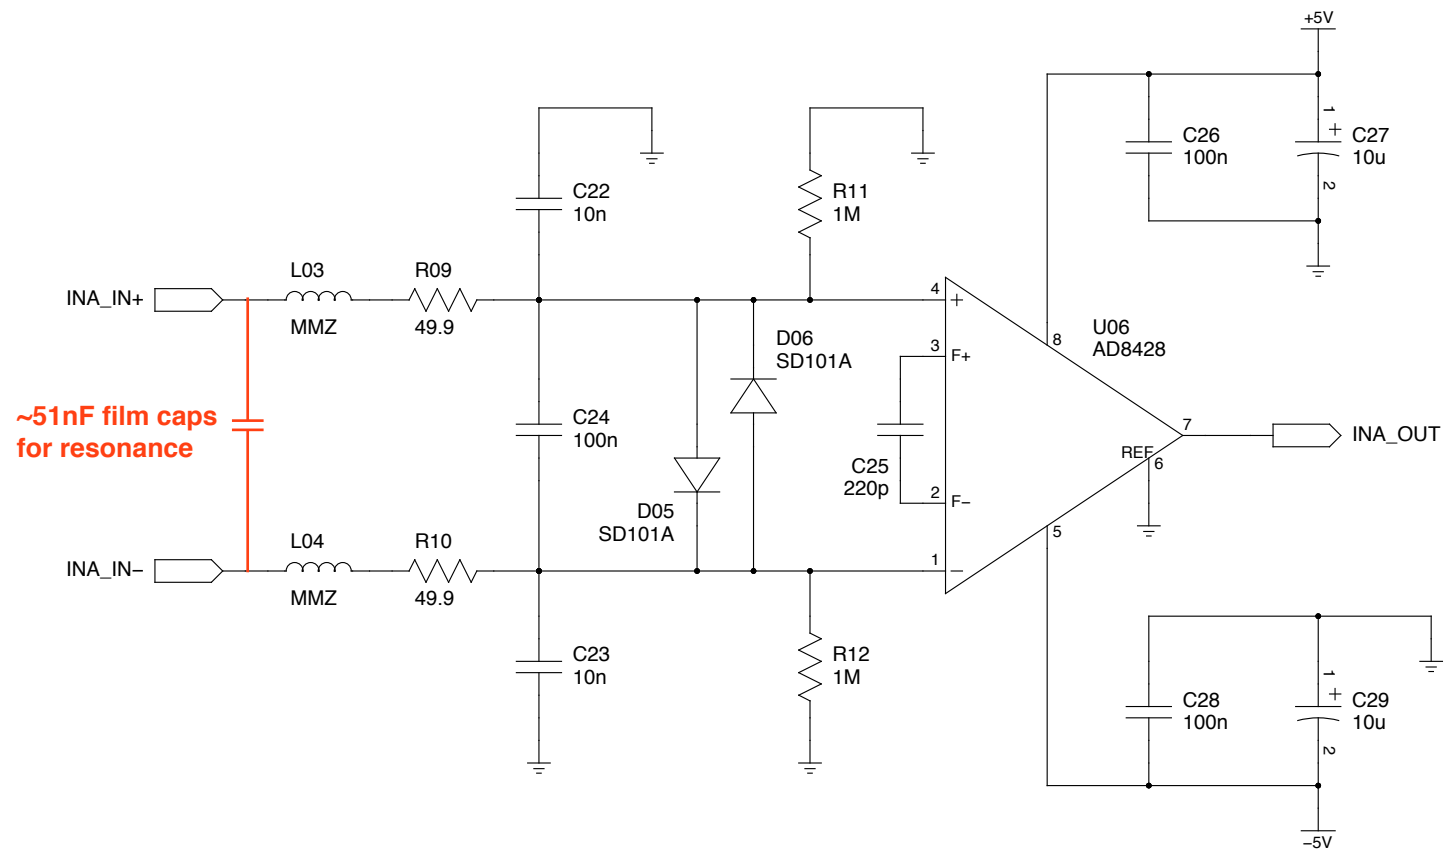


TITLE PPM I Instrumentation Amplifier

FILE: 07-asc-ina.sch

REVISION: 1.1

PAGE 7 OF 14

DRAWN BY: Bradley Worley

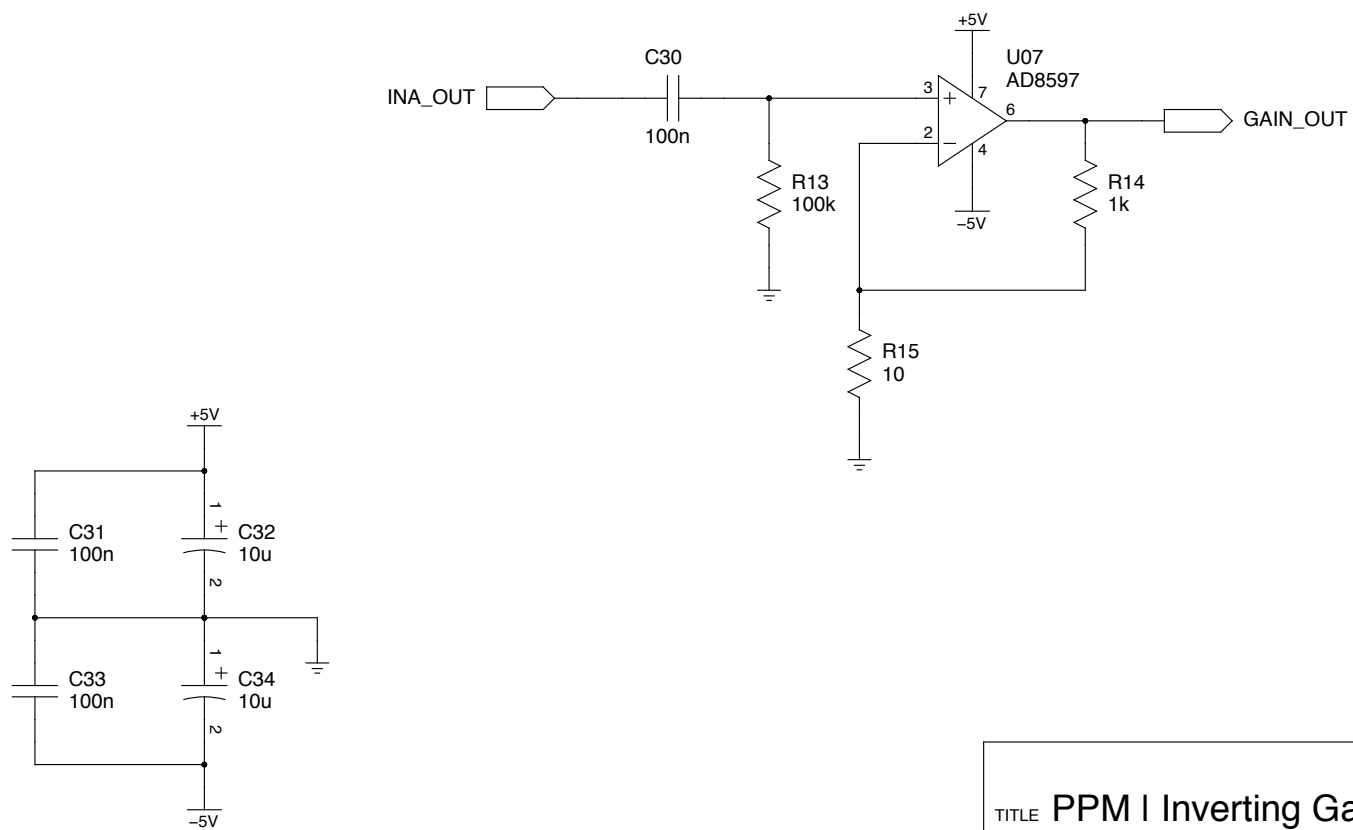


TITLE **PPM I Inverting Gain Stage**

FILE: 08-asc-gain.sch

REVISION: 1.0

PAGE **8** OF **14**

DRAWN BY: Bradley Worley

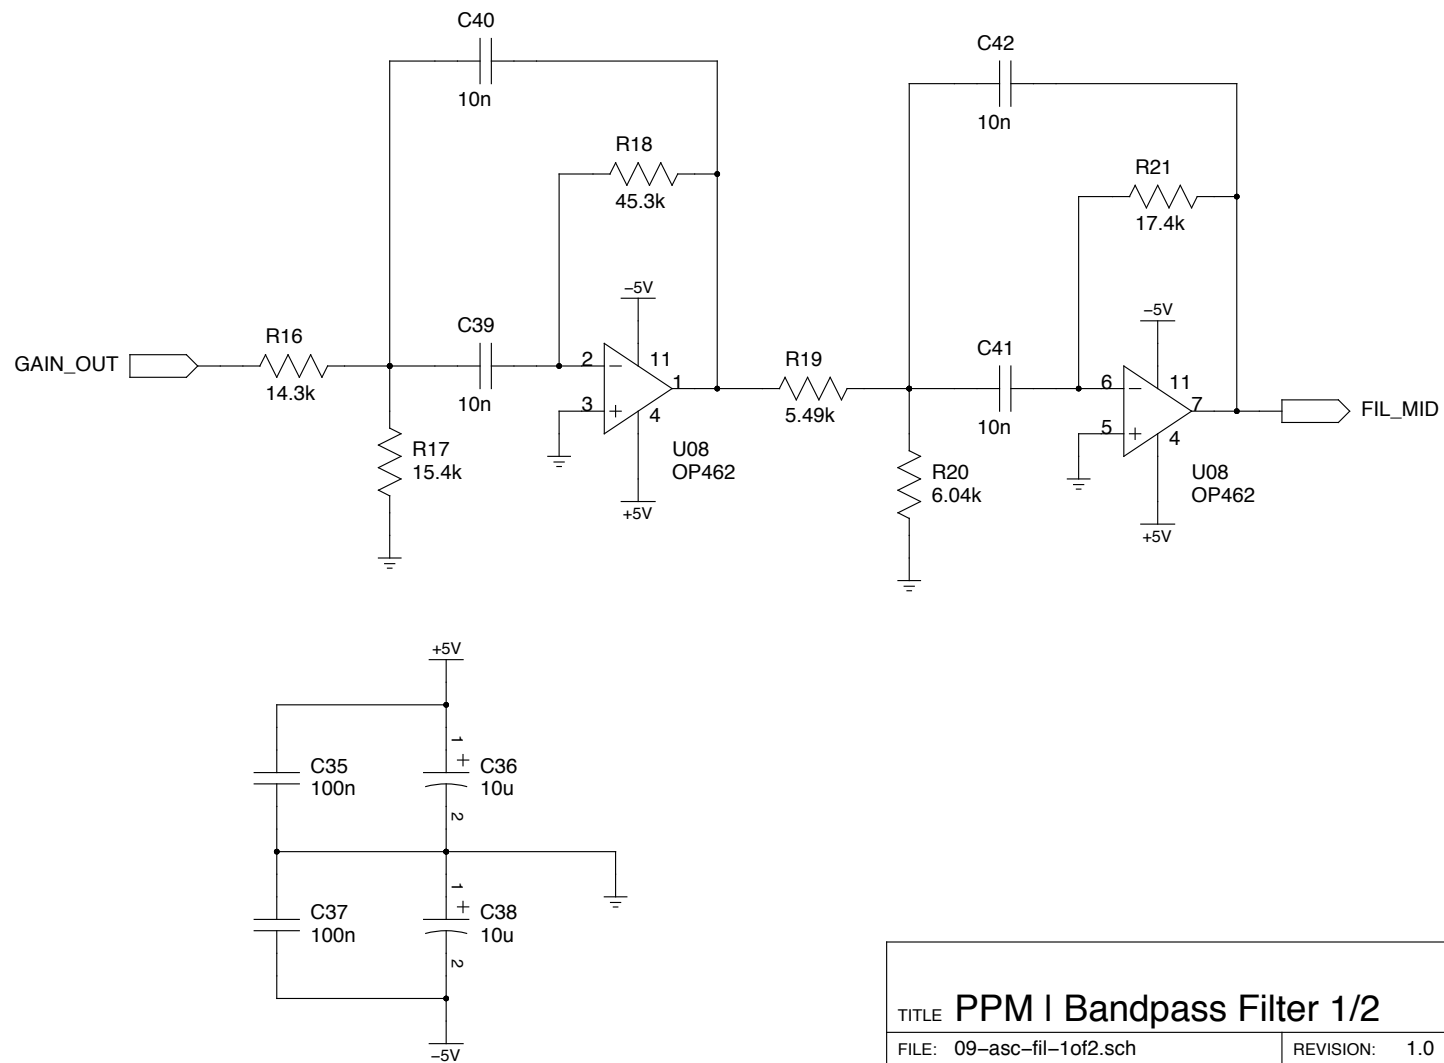


TITLE PPM I Bandpass Filter 1/2

FILE: 09-asc-fil-1of2.sch

REVISION: 1.0

PAGE 9 OF 14

DRAWN BY: Bradley Worley

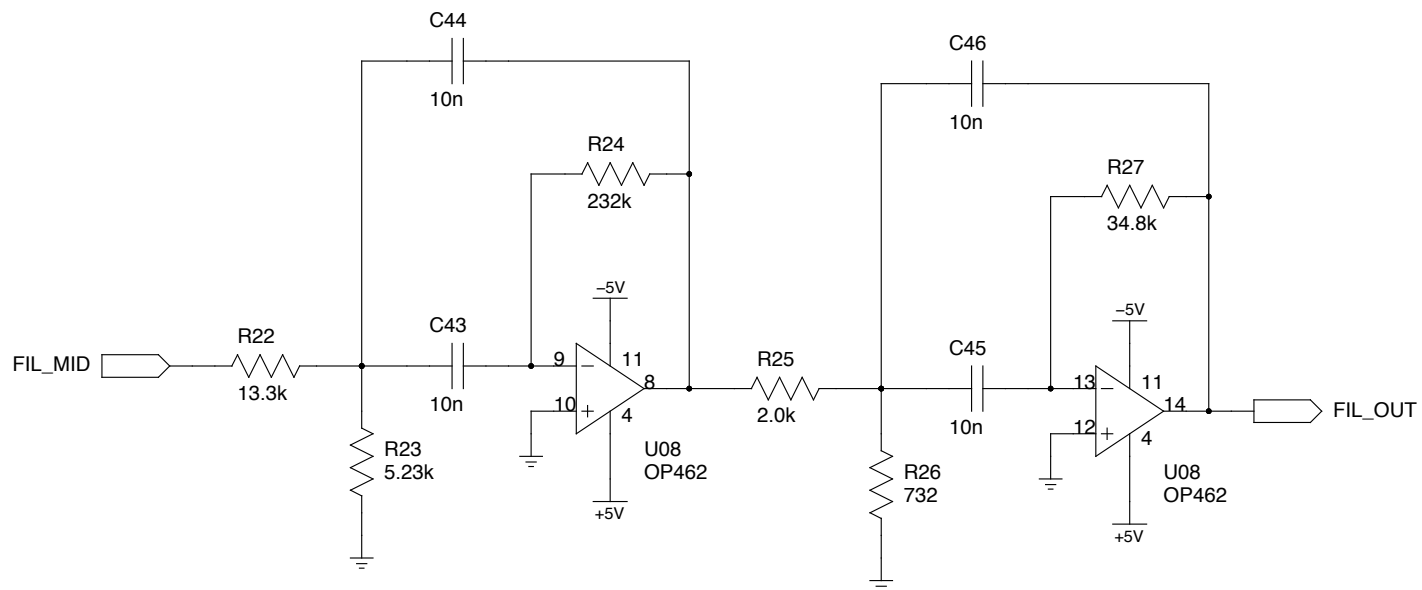


TITLE **PPM I Bandpass Filter 2/2**

FILE: 10-asc-fil-2of2.sch

REVISION: 1.0

PAGE 10 OF 14

DRAWN BY: Bradley Worley

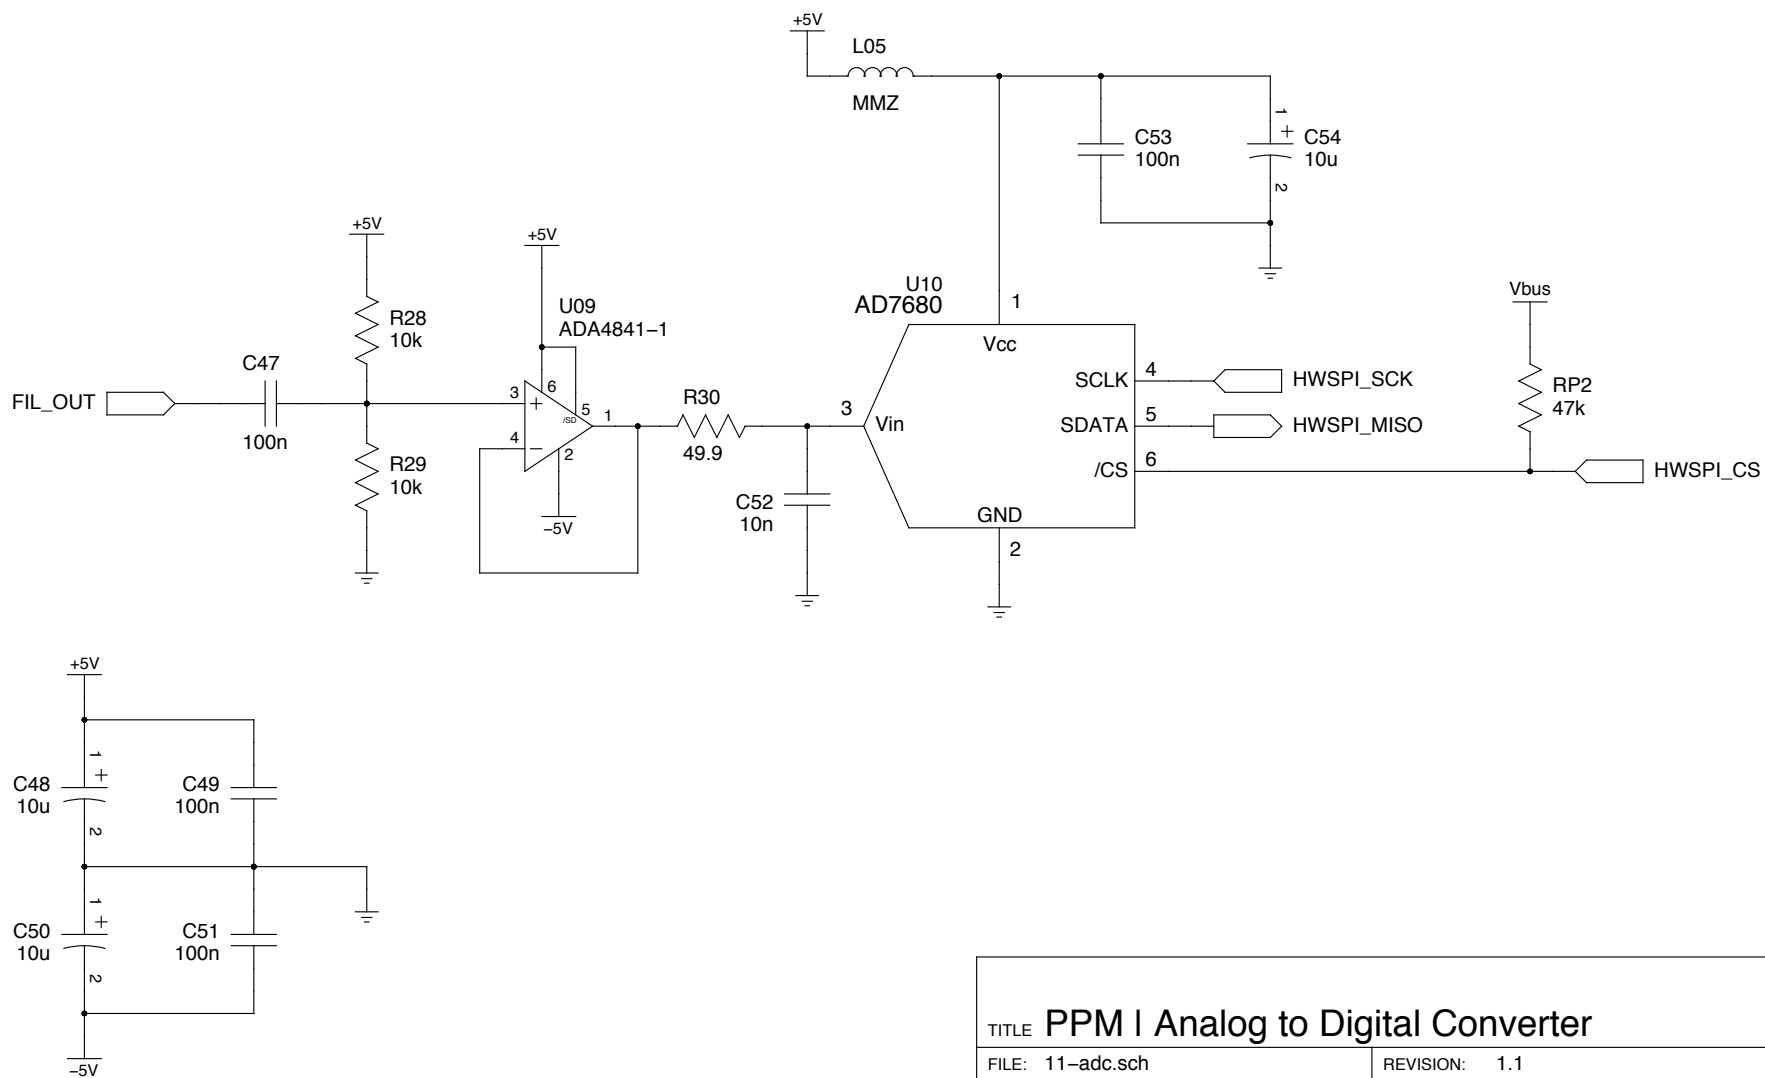


TITLE PPM I Analog to Digital Converter

FILE: 11-adc.sch

REVISION: 1.1

PAGE 11 OF 14

DRAWN BY: Bradley Worley

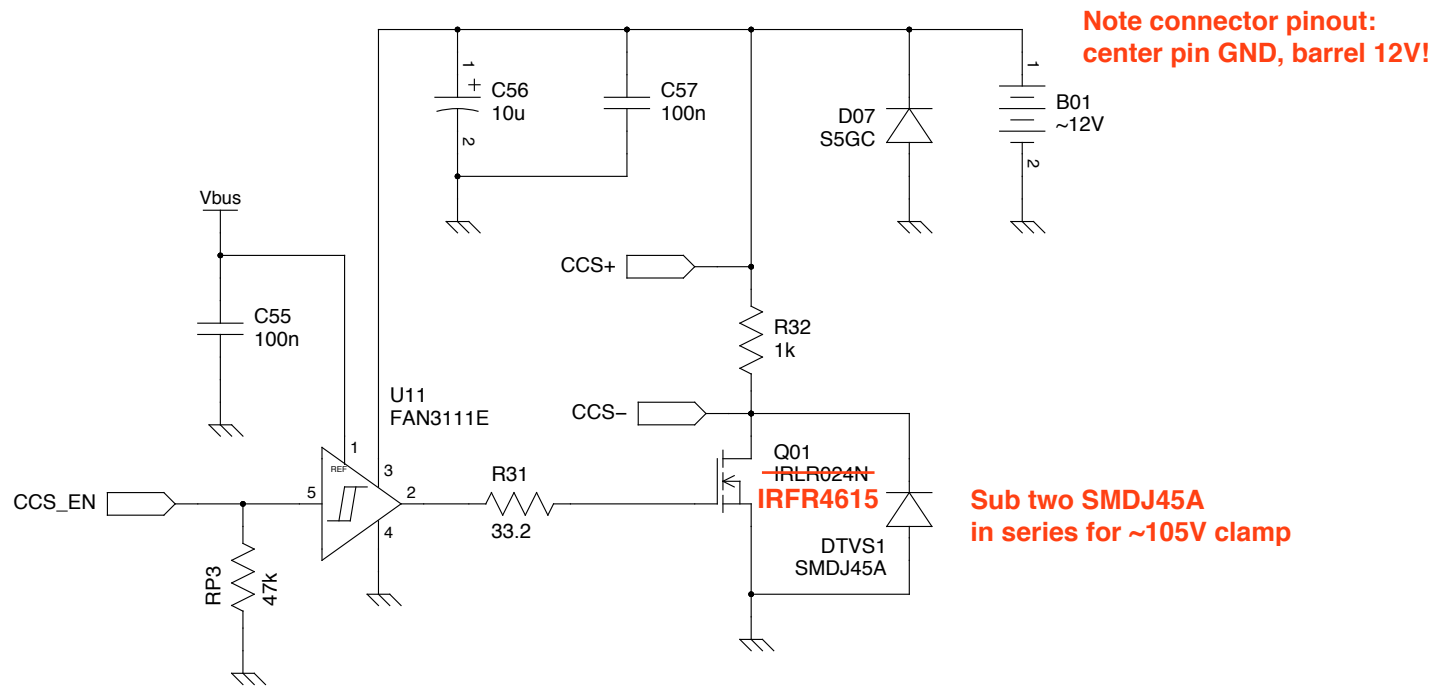

TITLE **PPM I Polarization Current Sink**

FILE: 12-pol.sch

REVISION: 2.1


PAGE 12 OF 14

DRAWN BY: Bradley Worley

Coil note: Two coils in series, counter-wound, 33.0 mH total.

**As installed @1KHz
(disconnected from J02):
150 ft 18AWG
33.15 mH, Q = 16.3
12.8 ohms**

**Shield capacitance:
21.3nF to each signal**

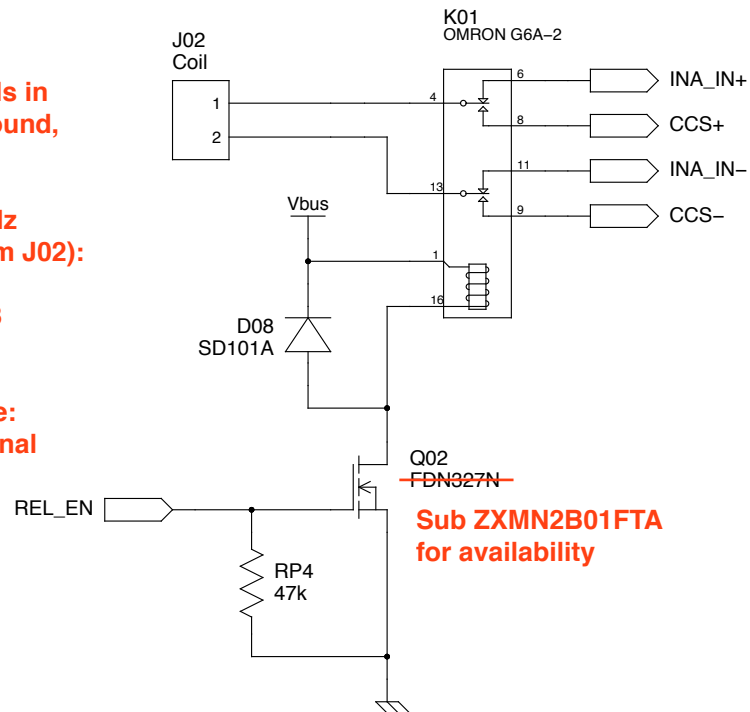




TITLE **PPM I Relay**

FILE: 13-relay.sch

PAGE **13** OF **14**

REVISION: **1.3**

DRAWN BY: **Bradley Worley**

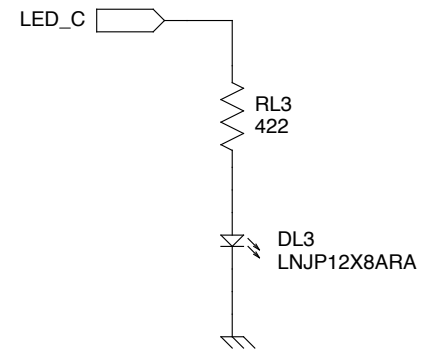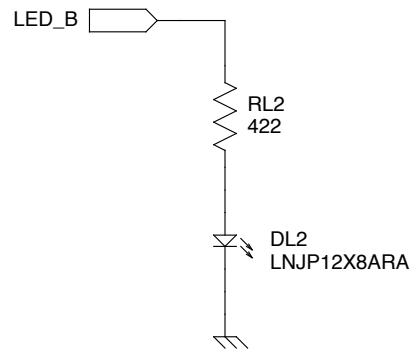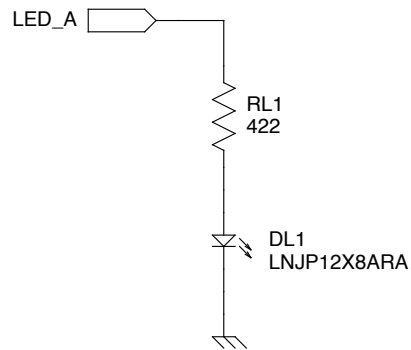

TITLE **PPM I LED Status Indicators**

FILE: 14-leds.sch

REVISION: 1.2

PAGE **14** OF **14**

DRAWN BY: Bradley Worley